


THIRD FLOOR PLAN (UNIT 57-33)
 SCALE: 1/8" = 1'-0"

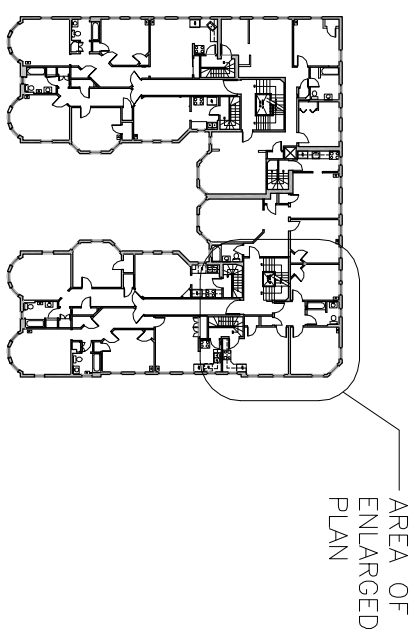

KEY PLAN
 SCALE: 1" = 50'-0"

I CERTIFY TO THE BEST OF MY KNOWLEDGE, INFORMATION AND BELIEF THAT THIS PLAN FULLY AND ACCURATELY DEPICTS UNIT 57-33, THE LAYOUT OF THE UNIT, ITS LOCATION, DIMENSIONS, APPROXIMATE AREA, MAIN ENTRANCE AND IMMEDIATE COMMON AREA TO WHICH IT HAS ACCESS, AS BUILT

CRAMER & LEVINE ARCHITECTS
 134 EAST MAIN STREET
 TEL (508) 230-2466

PROJECT:
57-59 MAGAZINE STREET CONDOMINIUM
57-59 MAGAZINE STREET
CAMBRIDGE, MA 02139

DRAWN BY: tm
 JOB # 04-072
 DATE: 1/3/06
 NUMBER: **3-33**
 CAD FILE: