


FIRST FLOOR PLAN (UNIT 57-4)
 SCALE: 1/8" = 1'-0"

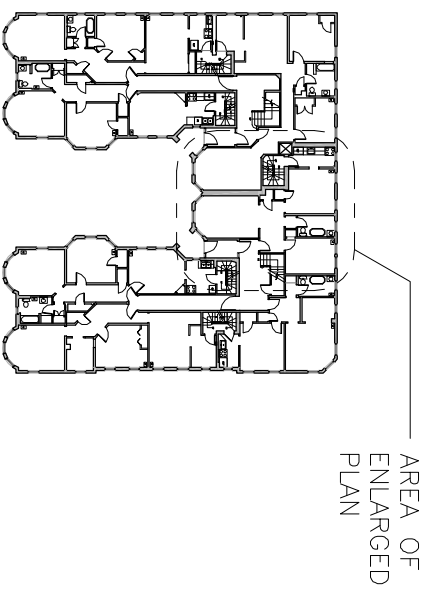

KEY PLAN
 SCALE: 1" = 50'-0"

I CERTIFY TO THE BEST OF MY KNOWLEDGE, INFORMATION AND BELIEF THAT THIS PLAN FULLY AND ACCURATELY DEPICTS UNIT 57-4, THE LAYOUT OF THE UNIT, ITS LOCATION, DIMENSIONS, APPROXIMATE AREA, MAIN ENTRANCE AND IMMEDIATE COMMON AREA TO WHICH IT HAS ACCESS, AS BUILT

CRAMER & LEVINE ARCHITECTS
 134 EAST MAIN STREET
 TEL (508) 230-2466
 NORTON, MA 02766
 FAX (774) 265-1811

PROJECT: **57-59 MAGAZINE STREET CONDOMINIUM**
57-59 MAGAZINE STREET
CAMBRIDGE, MA 02139

| | | | |
|-----------|--------|---------|-----|
| DRAWN BY: | tm | NUMBER: | 1-4 |
| JOB # | 04-072 | | |
| DATE: | 1/3/06 | | |
| CAD FILE: | | | |