


I CERTIFY TO THE BEST OF MY KNOWLEDGE, INFORMATION AND BELIEF THAT THIS PLAN FULLY AND ACCURATELY DEPICTS UNIT 59-7, THE LAYOUT OF THE UNIT, ITS LOCATION, DIMENSIONS, APPROXIMATE AREA, MAIN ENTRANCE AND IMMEDIATE COMMON AREA TO WHICH IT HAS ACCESS, AS BUILT

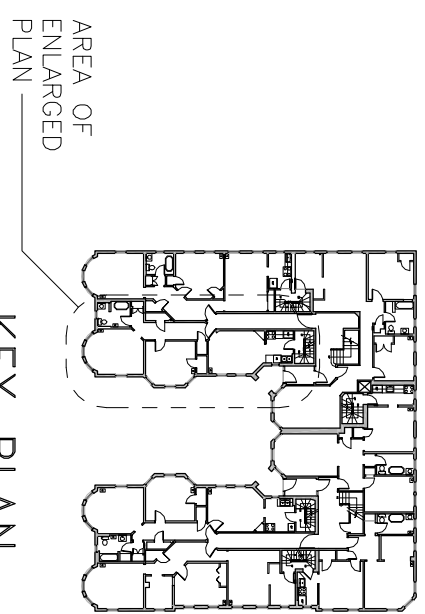

KEY PLAN
SCALE: 1" = 50'-0"

FIRST FLOOR PLAN (UNIT 59-7)

SCALE: 3/32" = 1'-0"

PROJECT:

**57-59 MAGAZINE STREET
CONDOMINIUM**
57-59 MAGAZINE STREET
CAMBRIDGE, MA 02139

CRAMER & LEVINE
ARCHITECTS
134 EAST MAIN STREET
NORTON, MA 02766
TEL (508) 230-2466
FAX (774) 265-1811

DRAWN BY: tm

NUMBER:

JOB # 04-072

1-7

DATE: 1/3/06

CAD FILE: