


I CERTIFY TO THE BEST OF MY KNOWLEDGE, INFORMATION AND BELIEF THAT THIS PLAN FULLY AND ACCURATELY DEPICTS UNIT 59-35, THE LAYOUT OF THE UNIT, ITS LOCATION, DIMENSIONS, APPROXIMATE AREA, MAIN ENTRANCE AND IMMEDIATE COMMON AREA TO WHICH IT HAS ACCESS, AS BUILT

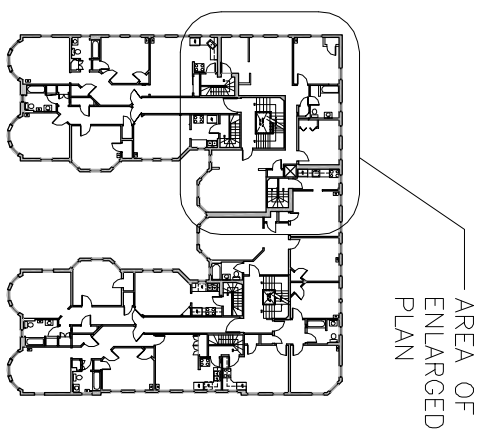


### KEY PLAN

SCALE: 1" = 50'-0"

## THIRD FLOOR PLAN (UNIT 59-35)

SCALE: 1/8" = 1'-0"



**CRAMER & LEVINE**

REGISTERED PROFESSIONAL ARCHITECTS

134 EAST MAIN STREET  
TEL (508) 230-2466

NORTON, MA 02766  
FAX (774) 265-1811

PROJECT:

**57-59 MAGAZINE STREET CONDOMINIUM**

**57-59 MAGAZINE STREET**

**CAMBRIDGE, MA 02139**

DRAWN BY: tm

NUMBER: 3-35

JOB # 04-072

DATE: 1/3/06

CAD FILE: