


I CERTIFY TO THE BEST OF MY KNOWLEDGE, INFORMATION AND BELIEF THAT THIS PLAN FULLY AND ACCURATELY DEPICTS UNIT 59-6, THE LAYOUT OF THE UNIT, ITS LOCATION, DIMENSIONS, APPROXIMATE AREA, MAIN ENTRANCE AND IMMEDIATE COMMON AREA TO WHICH IT HAS ACCESS, AS BUILT

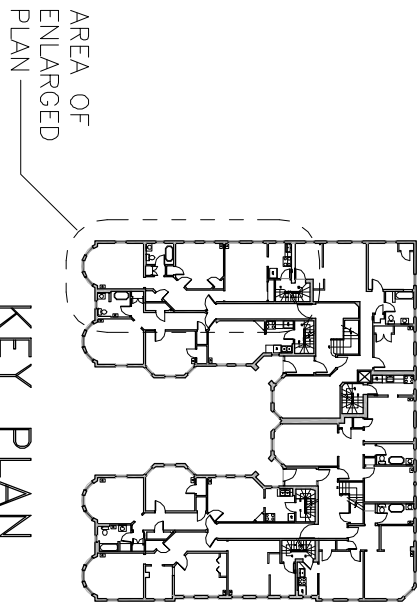

KEY PLAN
SCALE: 1" = 50'-0"

FIRST FLOOR PLAN (UNIT 59-6)

SCALE: 3/32" = 1'-0"


PROJECT:

DRAWN BY:

NUMBER:

JOB # 04-072
DATE: 1/3/06

1-6



CRAMER & LEVINE

ARCHITECTS

134 EAST MAIN STREET
TEL (508) 230-2466

NORTON, MA 02766
FAX (774) 265-1811

**57-59 MAGAZINE STREET
CONDOMINIUM**
57-59 MAGAZINE STREET
CAMBRIDGE, MA 02139

CAD FILE: