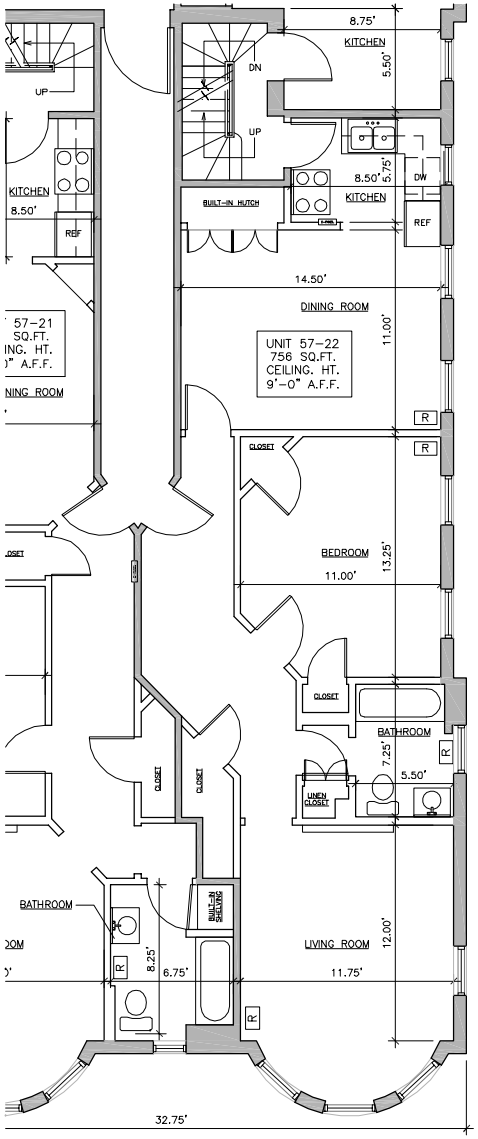

I CERTIFY TO THE BEST OF MY KNOWLEDGE, INFORMATION AND BELIEF THAT THIS PLAN FULLY AND ACCURATELY DEPICTS UNIT 57–22, THE LAYOUT OF THE UNIT, ITS LOCATION, DIMENSIONS, APPROXIMATE AREA, MAIN ENTRANCE AND IMMEDIATE COMMON AREA TO WHICH IT HAS ACCESS, AS BUILT

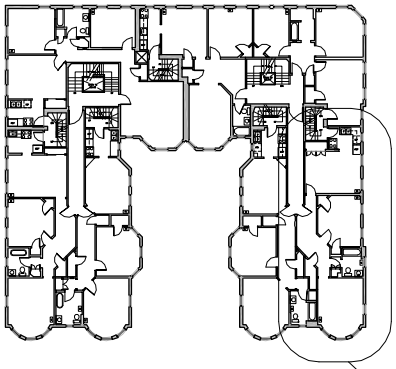

AREA OF ENLARGED PLAN

KEY PLAN

SCALE: 1"= 50'–0"

SECOND FLOOR PLAN (UNIT 57–22)

SCALE: 3/32"= 1'–0"

CRAMER ▪ LEVINE
& C O M P A N Y
A R C H I T E C T S
134 EAST MAIN STREET NORTON, MA 02766
TEL (508) 230–2466 FAX (774) 265–1811

PROJECT:

57-59 MAGAZINE STREET CONDOMINIUM

57-59 MAGAZINE STREET
CAMBRIDGE, MA 02139

DRAWN BY:	tm
JOB #	04–072
DATE:	1/3/06
CAD FILE:	

NUMBER: 2 – 22